

LEGEND


- COUNTY LINE
- CORPORATE LIMITS
- STATE TRUNKLINE
- COUNTY PRIMARY
- COUNTY LOCAL
- ADJACENT COUNTY
- CITY OR VILLAGE STREET

PRIMARY ROAD SYSTEM IS 9.22 MILES
 LOCAL ROAD SYSTEM IS 46.21 MILES

I HEREBY CERTIFY THAT THE ROADS SHOWN HEREON BY SYMBOL OR IN RED AS PRIMARY ROADS AND THOSE SHOWN HEREON BY SYMBOL OR IN GREEN AS LOCAL ROADS ARE IN USE AND ARE UNDER THE JURISDICTION OF THE COUNTY ROAD COMMISSION.

CHAIRMAN _____ DATE 10/28

REV. 1990
 REV. 1991
 REV. 1-1993
 REV. 5-1994
 REV. 1-1995
 REV. 2004

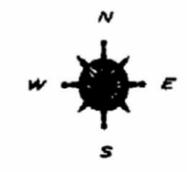


SCALE 0 1 MILE
 One Inch Equals 3000 Ft.

CHERRY GROVE TWP.
 T 21 N - R 10 W
 WEXFORD COUNTY

13	14	15	16
9	10	11	12
5	6	7	8
1	2	3	4



LAKE MITCHELL

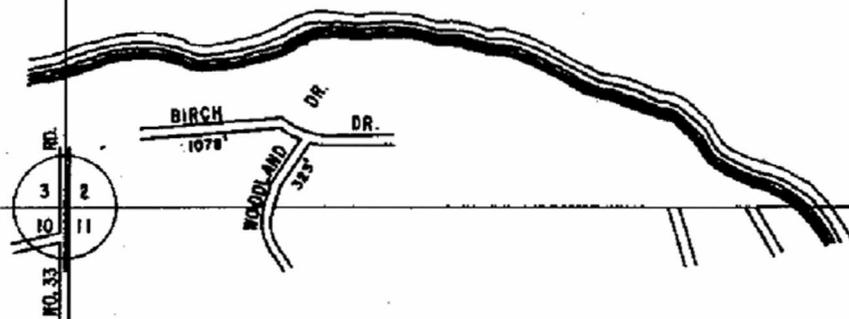

35 36
2 1


LEGEND

COUNTY LINE _____
CORPORATE LIMITS _____
STATE TRUNKLINE _____
COUNTY PRIMARY _____
COUNTY LOCAL _____
ADJACENT COUNTY _____
CITY OR VILLAGE _____
STREET _____

TOTAL FEET 1401 EQUALS 0.27 MILES

I HEREBY CERTIFY THAT THE ROADS SHOWN HEREON BY SYMBOL OR IN GREEN AS LOCAL ROADS ARE IN USE AND ARE UNDER THE JURISDICTION OF THE COUNTY ROAD COMMISSION.


CHAIRMAN ~~1933~~
DATE

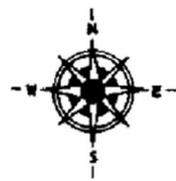

SCALE 0 600 1200 FEET
One inch equals 600 feet

TOWNSHIP CHERRY GROVE
SECTION 2 T. 21 N R. 10 W
COUNTY WEXFORD

2 1
11 12

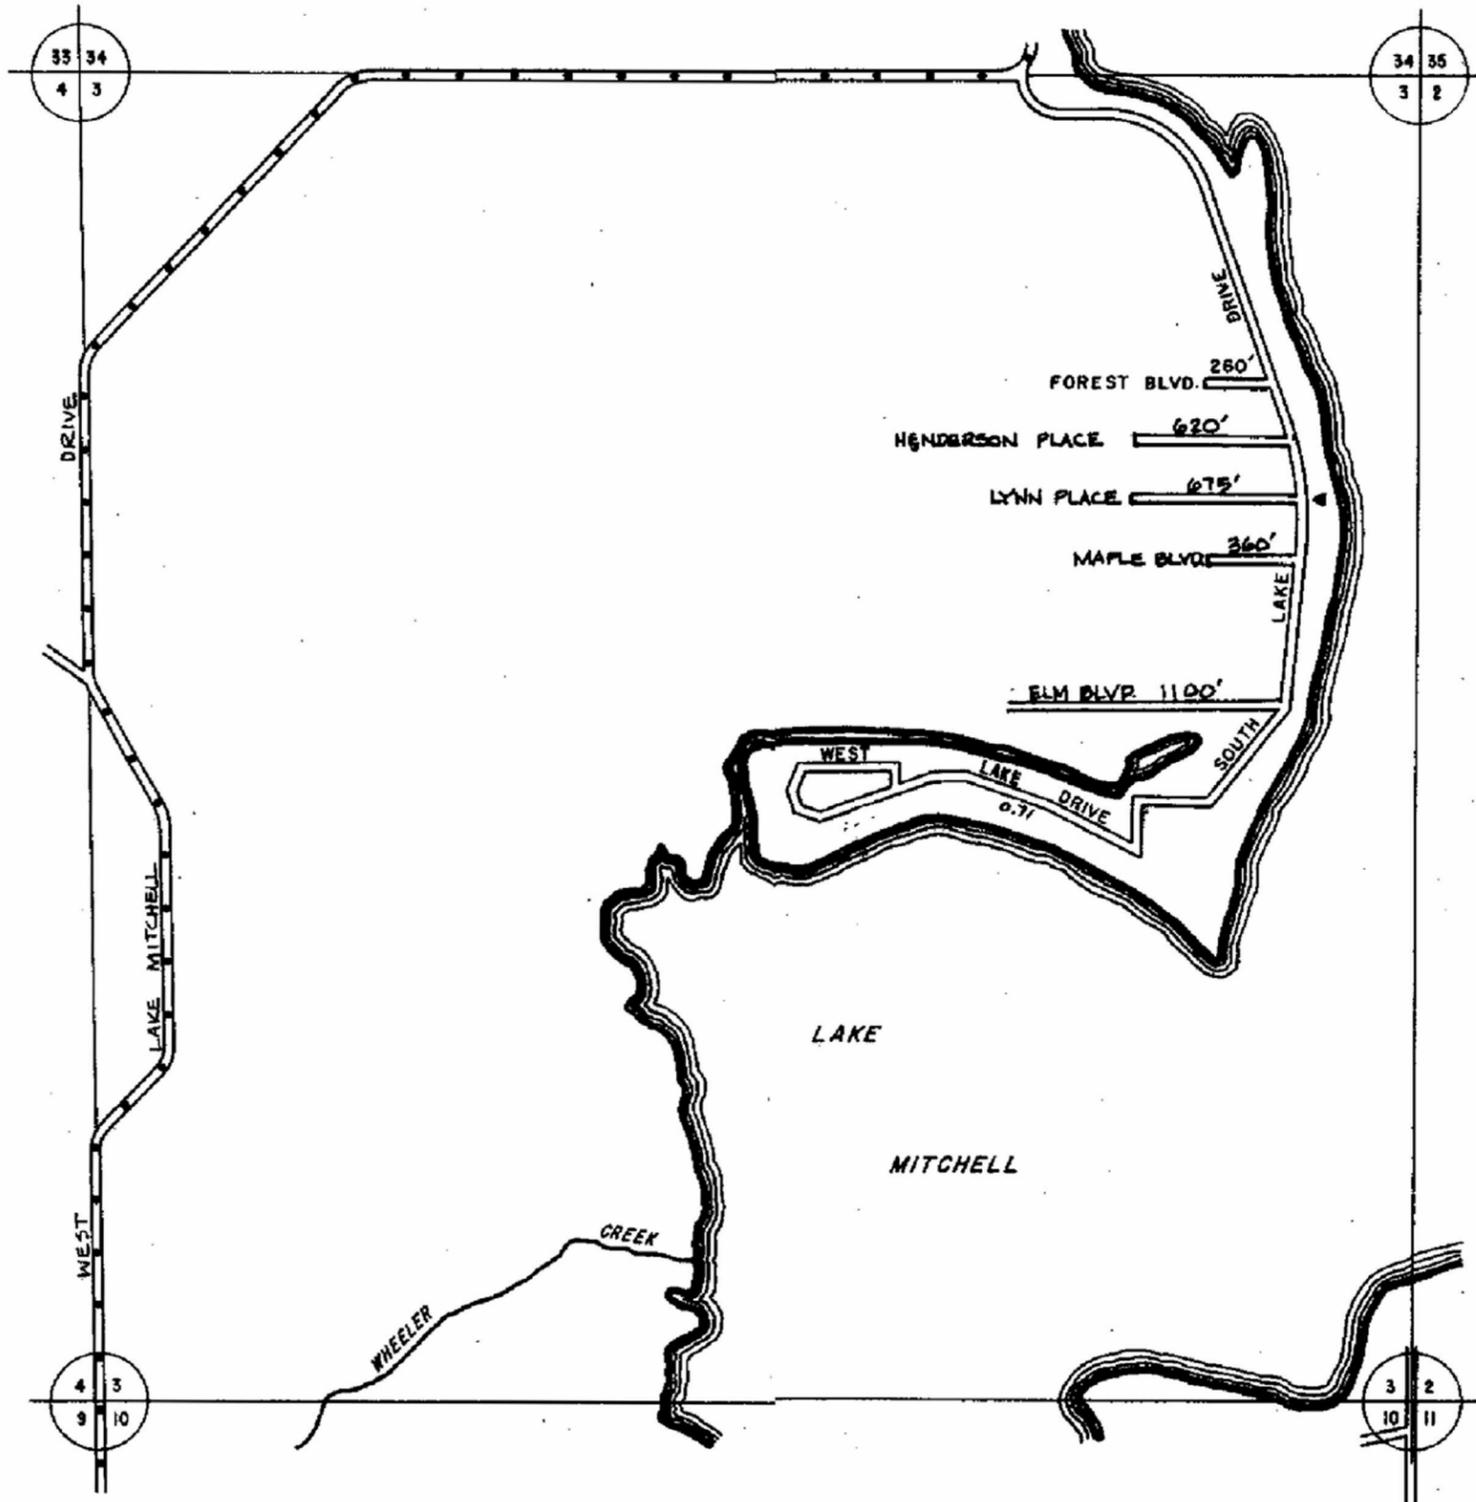

LEGEND

COUNTY LINE	-----
CORPORATE LIMITS	-----
STATE TRUNKLINE	=====
COUNTY PRIMARY	-----
COUNTY LOCAL	-----
ADJACENT COUNTY	
CITY OR VILLAGE	-----
STREET	-----

TOTAL FEET: 6743 EQUALS 1.28 MILES


I HEREBY CERTIFY THAT THE ROADS SHOWN HEREON BY SYMBOL OR IN GREEN AS LOCAL ROADS ARE IN USE AND ARE UNDER THE JURISDICTION OF THE COUNTY ROAD COMMISSION.


CHAIRMAN _____
 DATE 1988
 Rev (1980)
 Rev. 1991
 " (1996)
 Rev 2004



SCALE 0 600 1200 FEET
 One Inch equals 600 feet

TOWNSHIP CHERRY GROVE
 SECTION 3 T. 21 N. R. 10 W.
 COUNTY WEXFORD

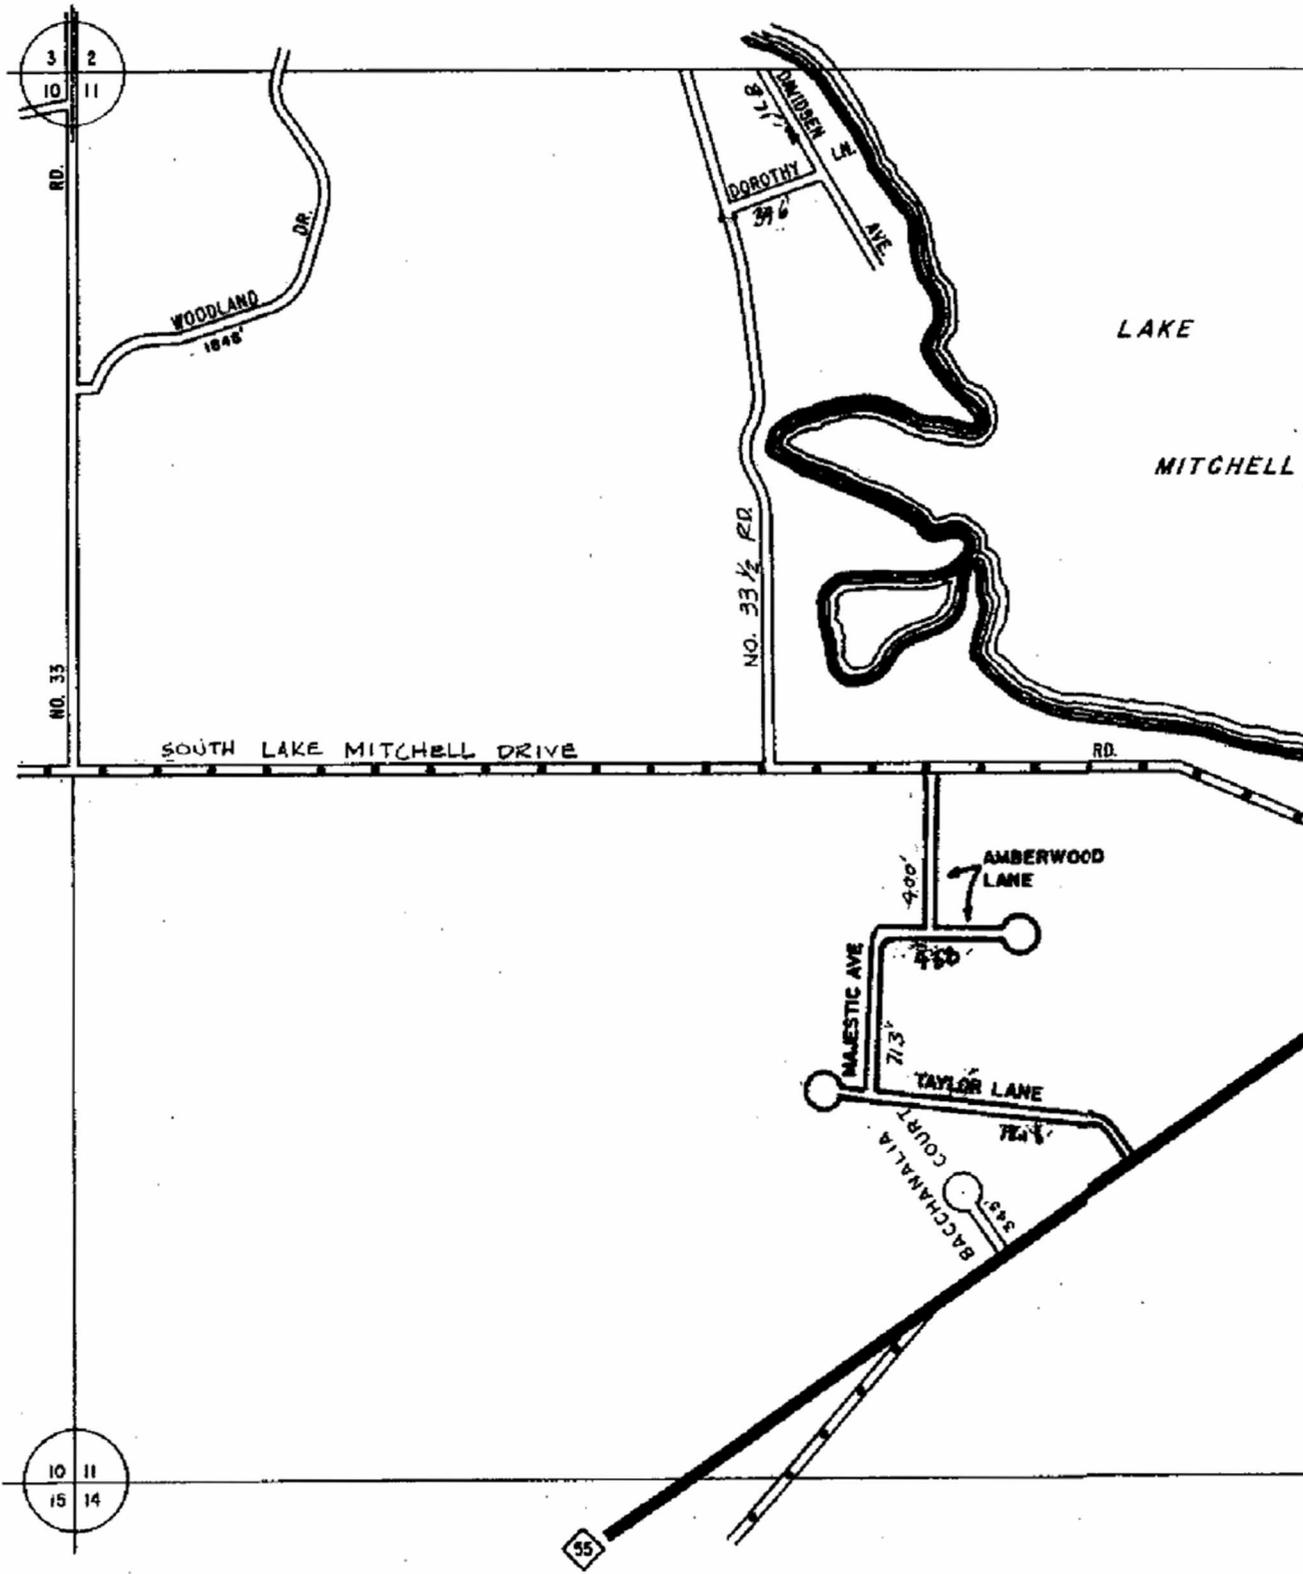

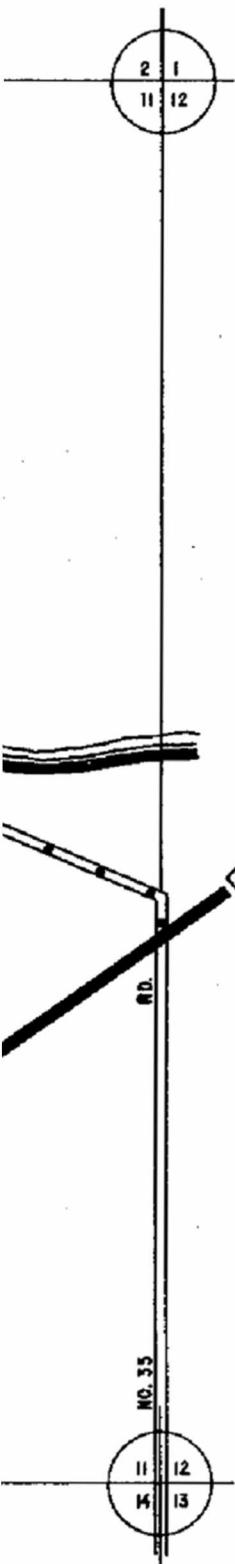

LEGEND

COUNTY LINE _____

CORPORATE LIMITS _____

STATE TRUNKLINE _____

COUNTY PRIMARY _____

COUNTY LOCAL _____

ADJACENT COUNTY _____

CITY OR VILLAGE _____

STREET _____

TOTAL FEET 6215 EQUALS 1.18 MILES

6215 1.18

I HEREBY CERTIFY THAT THE ROADS SHOWN HEREON BY SYMBOL OR IN GREEN AS LOCAL ROADS ARE IN USE AND ARE UNDER THE JURISDICTION OF THE COUNTY ROAD COMMISSION.

CHAIRMAN

1998
DATE

REV. 1998

Rev 2004




SCALE 0 600 1200 FEET


One inch equals 600 feet

TOWNSHIP CHERRY GROVE

SECTION 11 T. 21 N. R. 10 W.

COUNTY WEXFORD

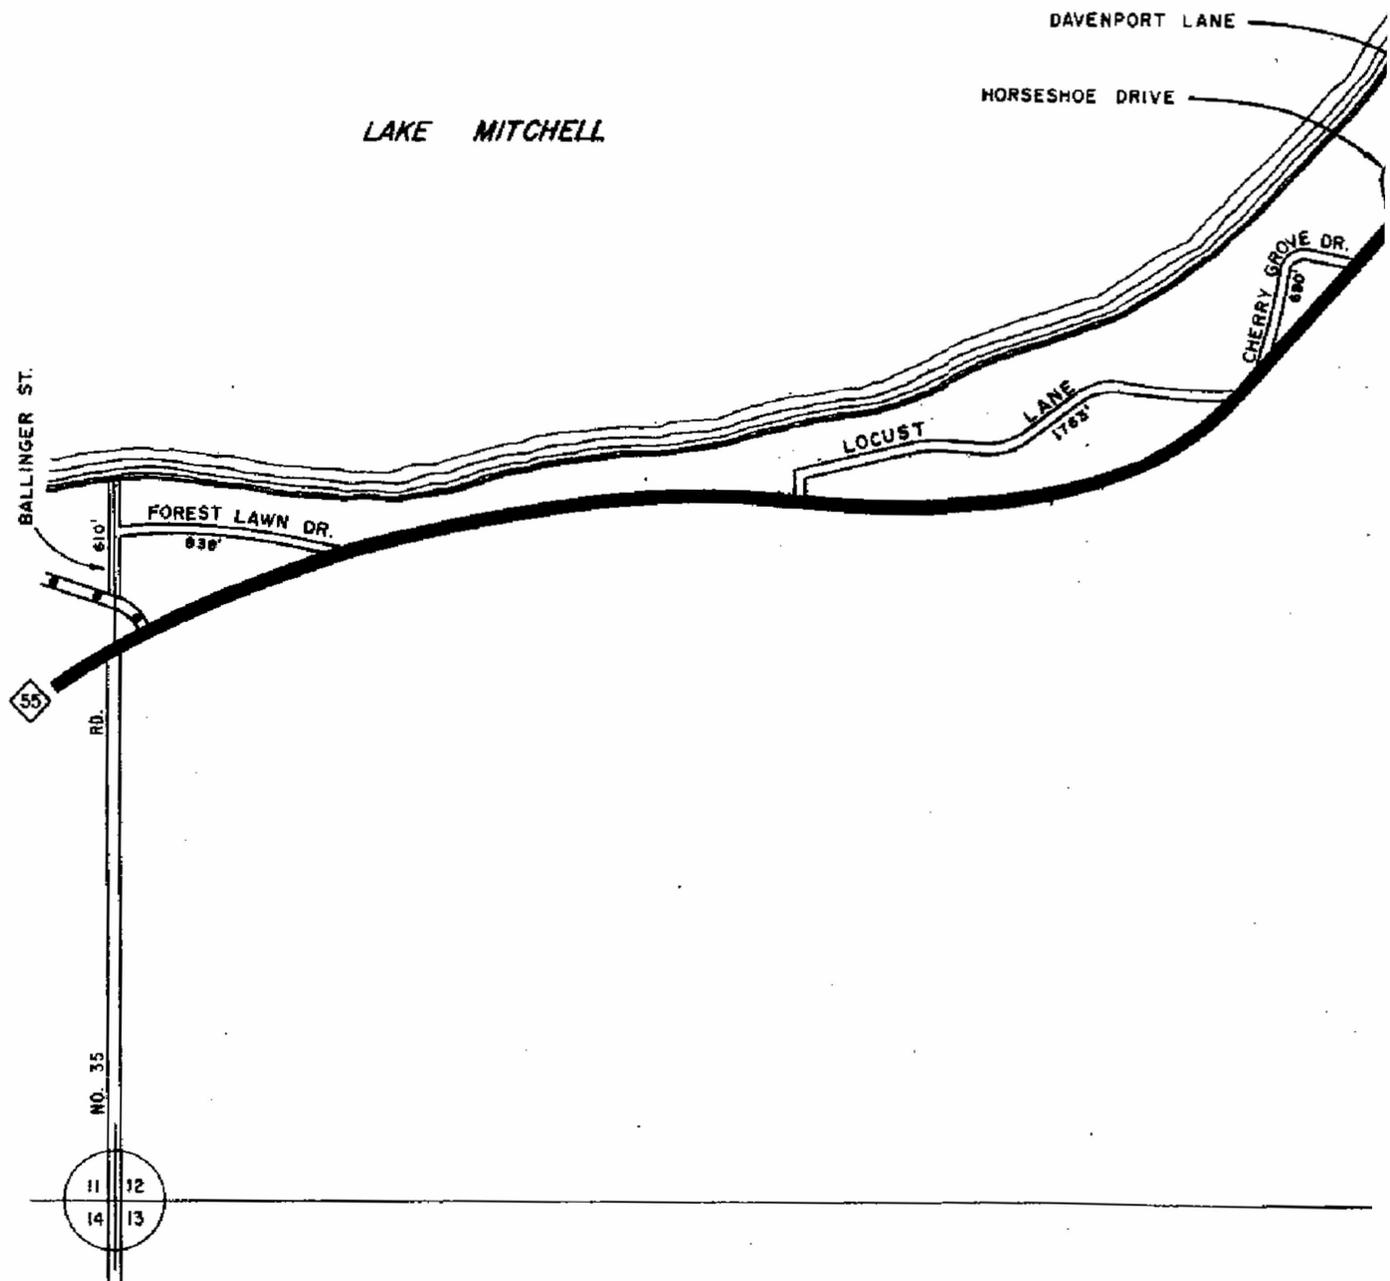

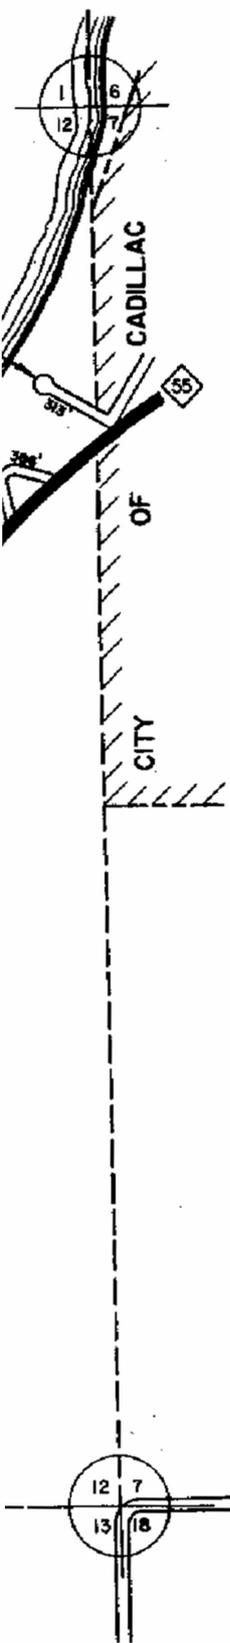

LEGEND

- COUNTY LINE
- CORPORATE LIMITS
- STATE TRUNKLINE
- COUNTY PRIMARY
- COUNTY LOCAL
- ADJACENT COUNTY
- CITY OR VILLAGE STREET

TOTAL FEET 4600 EQUALS 0.87 MILES

I HEREBY CERTIFY THAT THE ROADS SHOWN HEREOF BY SYMBOL OR IN GREEN AS LOCAL ROADS ARE IN USE AND ARE UNDER THE JURISDICTION OF THE COUNTY ROAD COMMISSION.


CHAIRMAN

1986
DATE
Rev. (1980)



SCALE 0 600 1200 FEET
One inch equals 600 feet

TOWNSHIP CHERRY GROVE
SECTION 12 T. 21 N R. 10 W
COUNTY WEXFORD

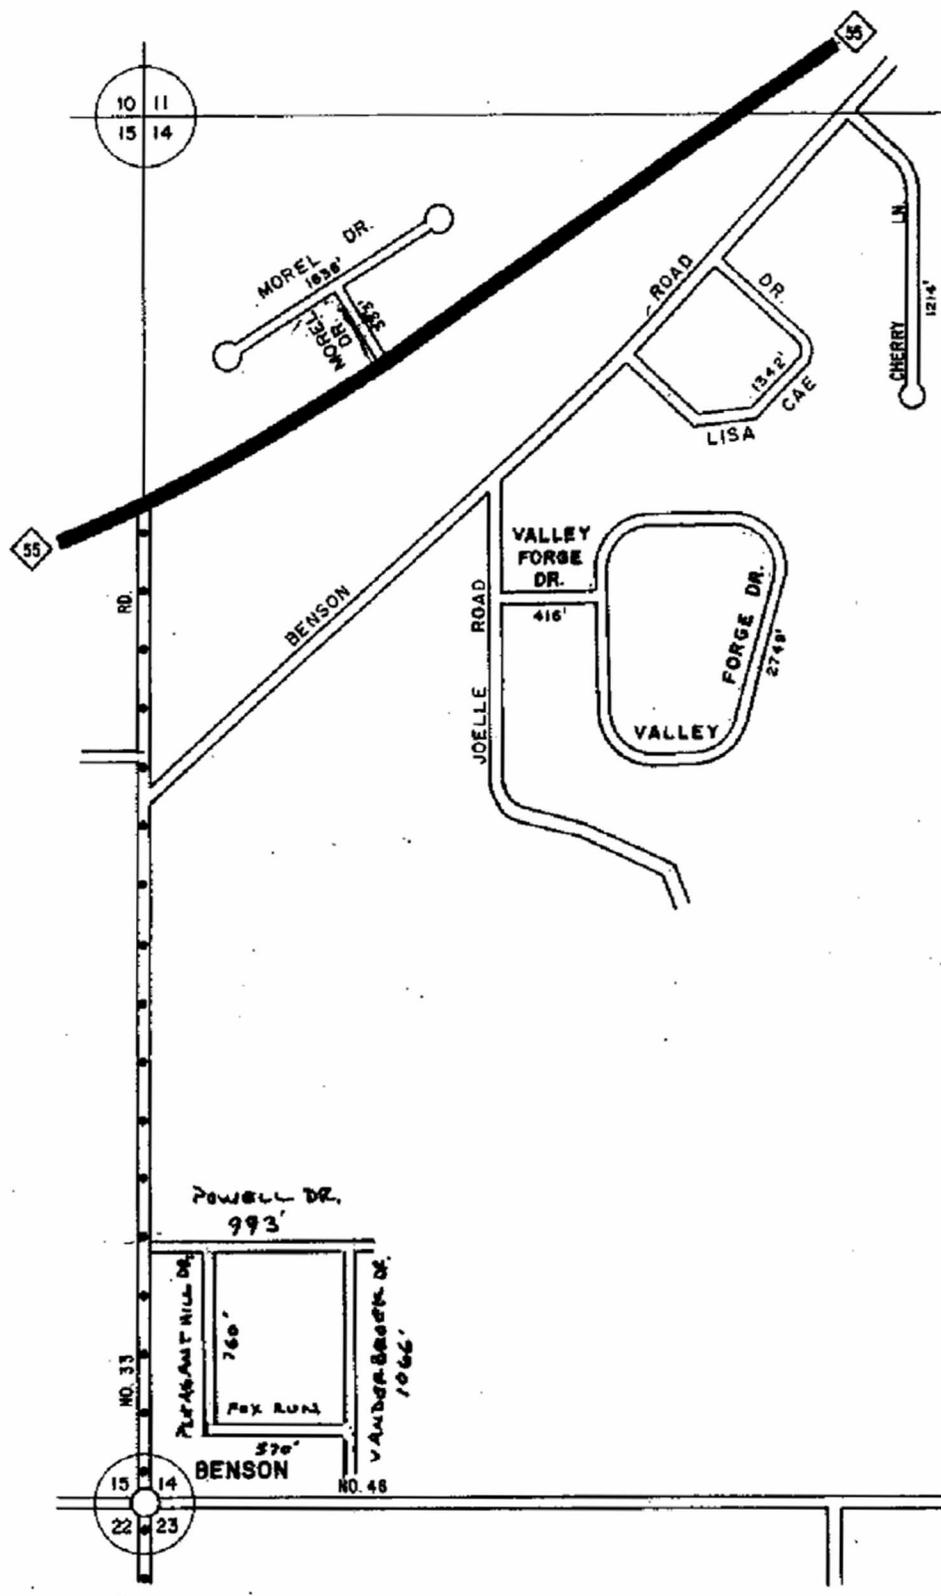

10 11
15 14

55

58

RD

MOREL DR.
1858'

MORSEL DR.
588'

ROAD

DR.

1342'
CAE

LISA

CHERRY LN.
1214'

BENSON

JOELLE ROAD

VALLEY FORGE DR.

416'

VALLEY

FORGE DR.

2748'

POWELL DR.
993'

PLANT MILL DR.

760'

FOX RUN

VANDERBROOK DR.


1066'

NO. 33

370'
BENSON

NO. 48

15 14
22 23

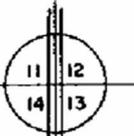

RD.

NO. 35



RD.

LEGEND

- COUNTY LINE
- CORPORATE LIMITS
- STATE TRUNKLINE
- COUNTY PRIMARY
- COUNTY LOCAL
- ADJACENT COUNTY
- CITY OR VILLAGE
- STREET

TOTAL FEET 11279 EQUALS 2.14 MILES

I HEREBY CERTIFY THAT THE ROADS SHOWN HEREON BY SYMBOL OR IN GREEN AS LOCAL ROADS ARE IN USE AND ARE UNDER THE JURISDICTION OF THE COUNTY ROAD COMMISSION.

CHAIRMAN

1998
DATE

REV. (1996)



SCALE 0 600 1200 FEET


One inch equals 600 feet

TOWNSHIP CHERRY GROVE

SECTION 14 T. 21N R. 10W

COUNTY WEXFORD

REV. 11-6-05 + 3389 BENBOW CORNERS
RLC ESTATE

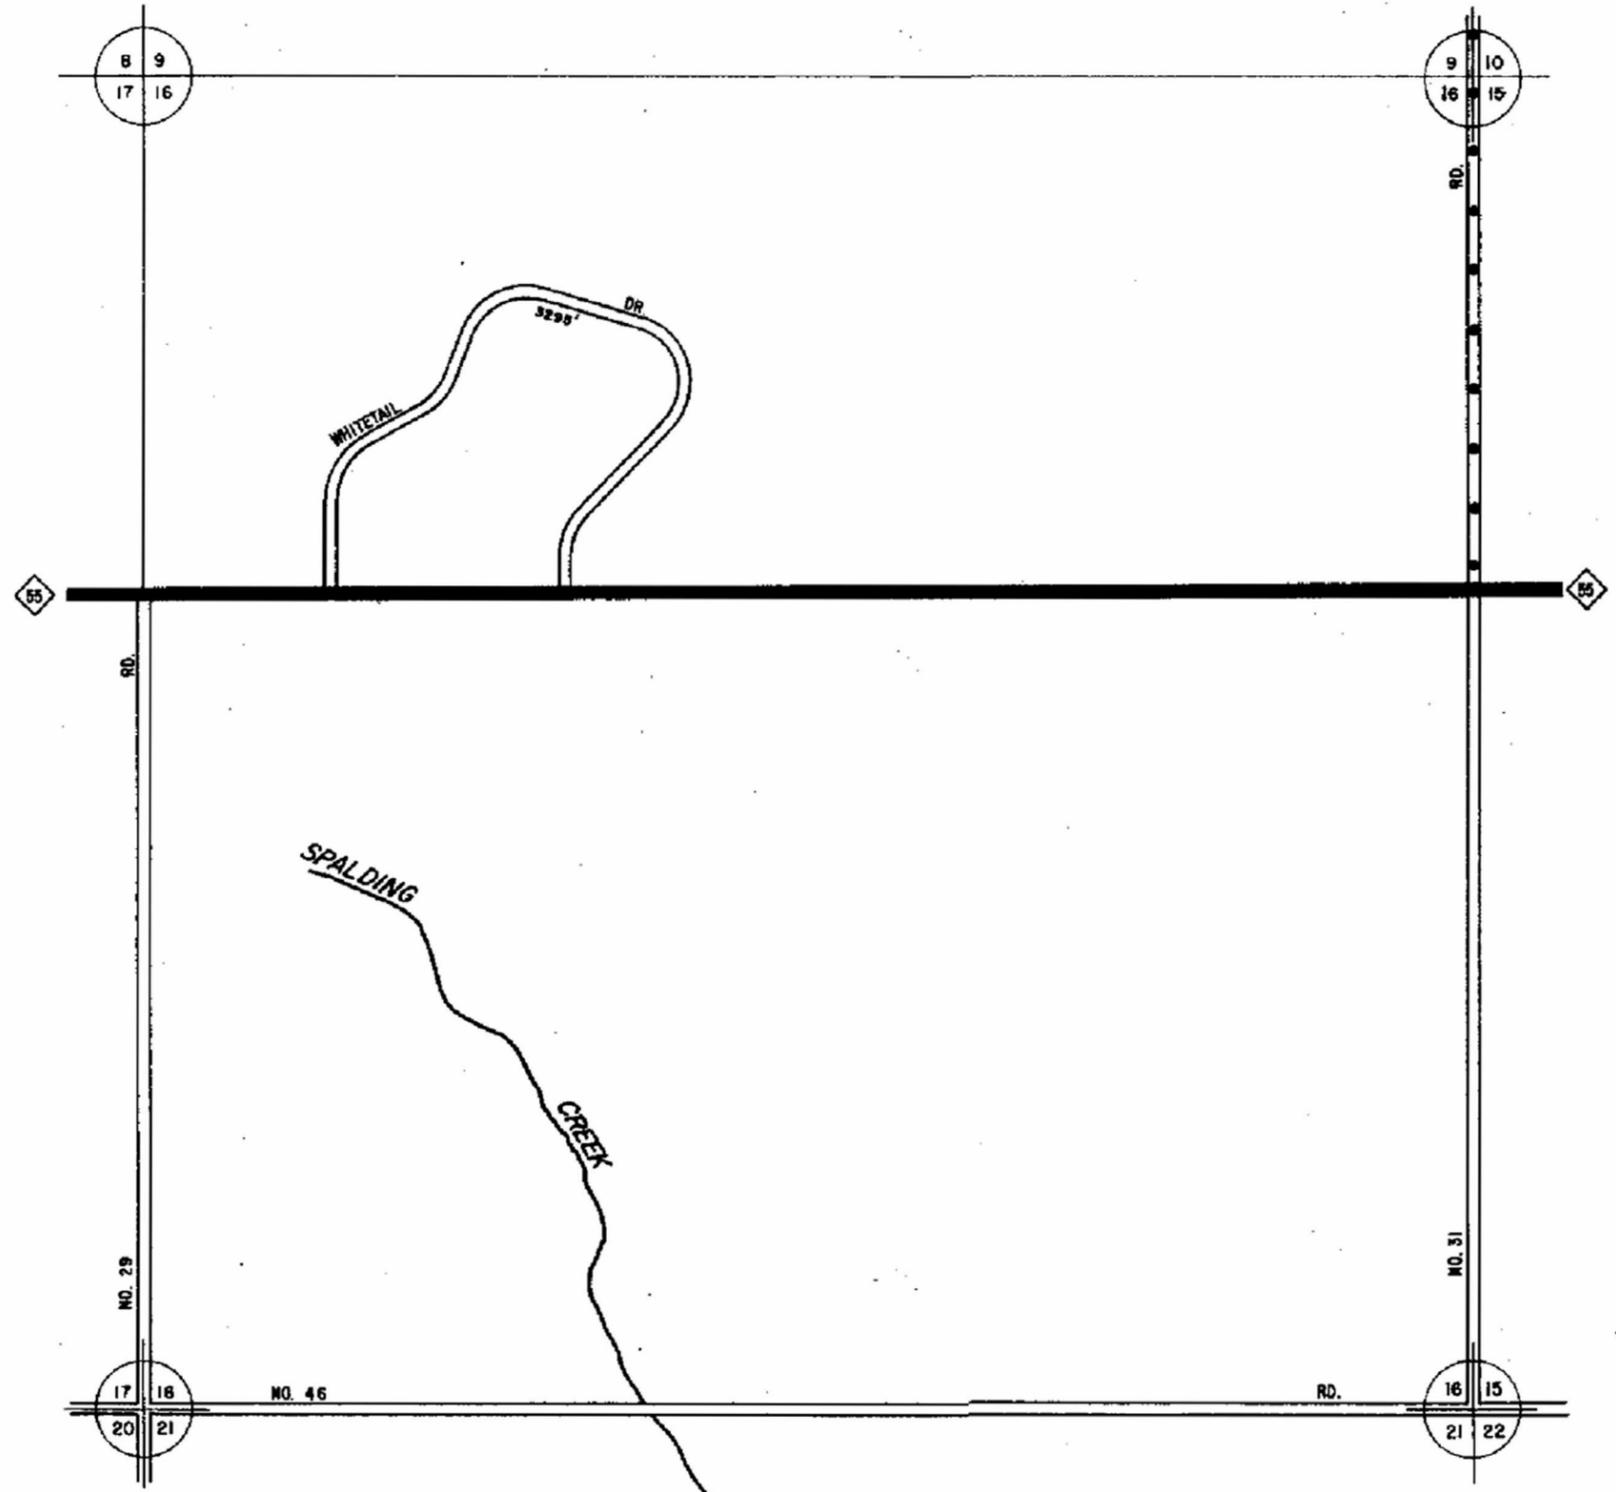

LEGEND

COUNTY LINE	—
CORPORATE LIMITS	—
STATE TRUNKLINE	—
COUNTY PRIMARY	—
COUNTY LOCAL	—
ADJACENT COUNTY	
CITY OR VILLAGE STREET	—

TOTAL FEET ~~3295~~ EQUALS 0.62 MILES

I HEREBY CERTIFY THAT THE ROADS SHOWN HEREON BY SYMBOL OR IN GREEN AS LOCAL ROADS ARE IN USE AND ARE UNDER THE JURISDICTION OF THE COUNTY ROAD COMMISSION.

CHAIRMAN 1998
DATE



SCALE 0 600 1200 FEET
One inch equals 600 feet

TOWNSHIP CHERRY GROVE
SECTION 16 T. 21 N R. 10 W
COUNTY WEXFORD

15 14
22 23

NO.

46

RD.

WEDGEWOOD
COURT 1534'

33

BIRCHWOOD

3232' LANE

NO.

LAKWOOD

GREENRIDGE DR.
800'

2085'

DR

22 23
27 26

RD.

14 13
23 24

LEGEND


COUNTY LINE	-----
CORPORATE LIMITS	-----
STATE TRUNKLINE	=====
COUNTY PRIMARY	-----
COUNTY LOCAL	-----
ADJACENT COUNTY	=====
CITY OR VILLAGE	=====
STREET	-----

TOTAL FEET 7624 EQUALS 1.44 MILES

I HEREBY CERTIFY THAT THE ROADS SHOWN HEREON BY SYMBOL OR IN GREEN AS LOCAL ROADS ARE IN USE AND ARE UNDER THE JURISDICTION OF THE COUNTY ROAD COMMISSION.

CHAIRMAN

1996
DAVE
1981 (New)
REV. 1991
REV. 1, 1993
REV 2006

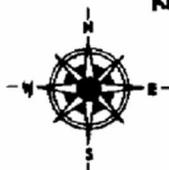


SCALE 0 600 1200 FEET
One inch equals 600 feet

TOWNSHIP CHERRY GROVE
SECTION 23 T. 21 N. R. 10 W
COUNTY WEXFORD

23 24
26 25

22 23
27 26

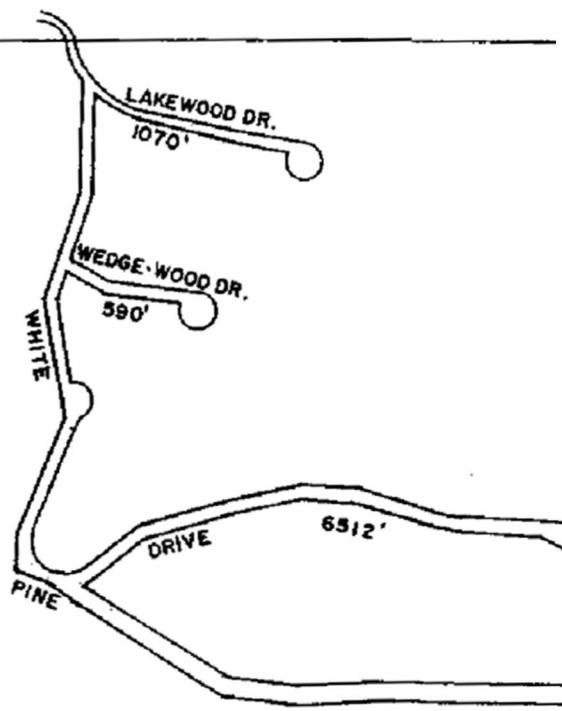


NO. 48 1/2 ROAD

33

NO.

27 26
34 35

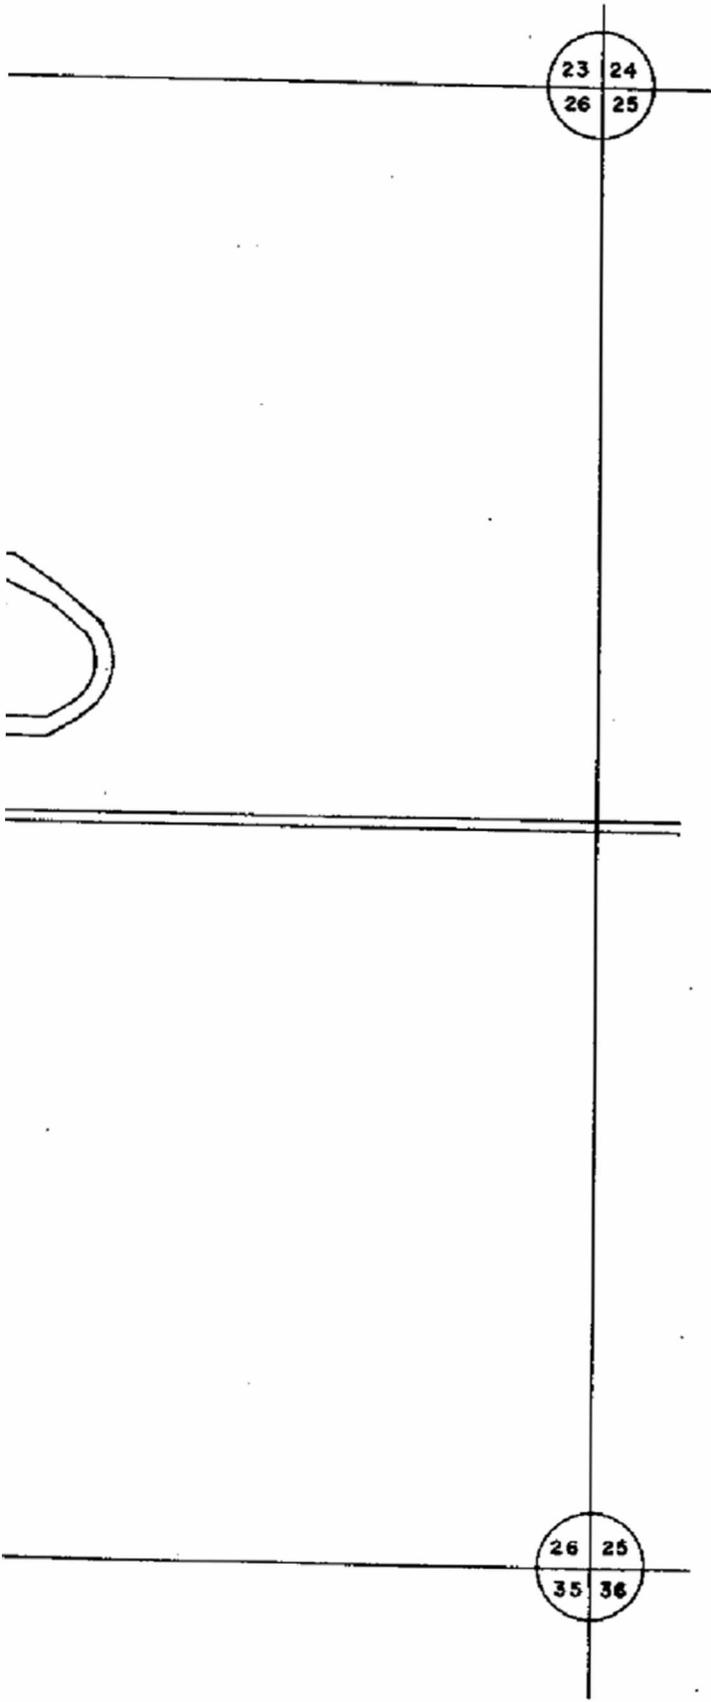


LEGEND

- COUNTY LINE
- CORPORATE LIMITS
- STATE TRUNKLINE
- COUNTY PRIMARY
- COUNTY LOCAL
- ADJACENT COUNTY
- CITY OR VILLAGE STREET

LOCAL ROAD SYSTEM

TOTAL FEET 8172 EQUALS 1.55 MILES

MILEAGES SHALL BE TO THE NEAREST ONE HUNDREDTH OF A MILE.

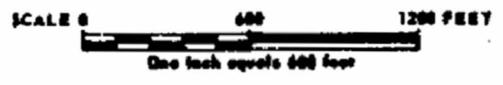

CHAIRMAN _____ DATE 1993
 REV. 1-1995
 " 1996


REVISED BY _____

DATE 1, 1994

TOWNSHIP CHERRY GROVE

SECTION 26 T. 21N. R. 10W.

COUNTY WEXFORD

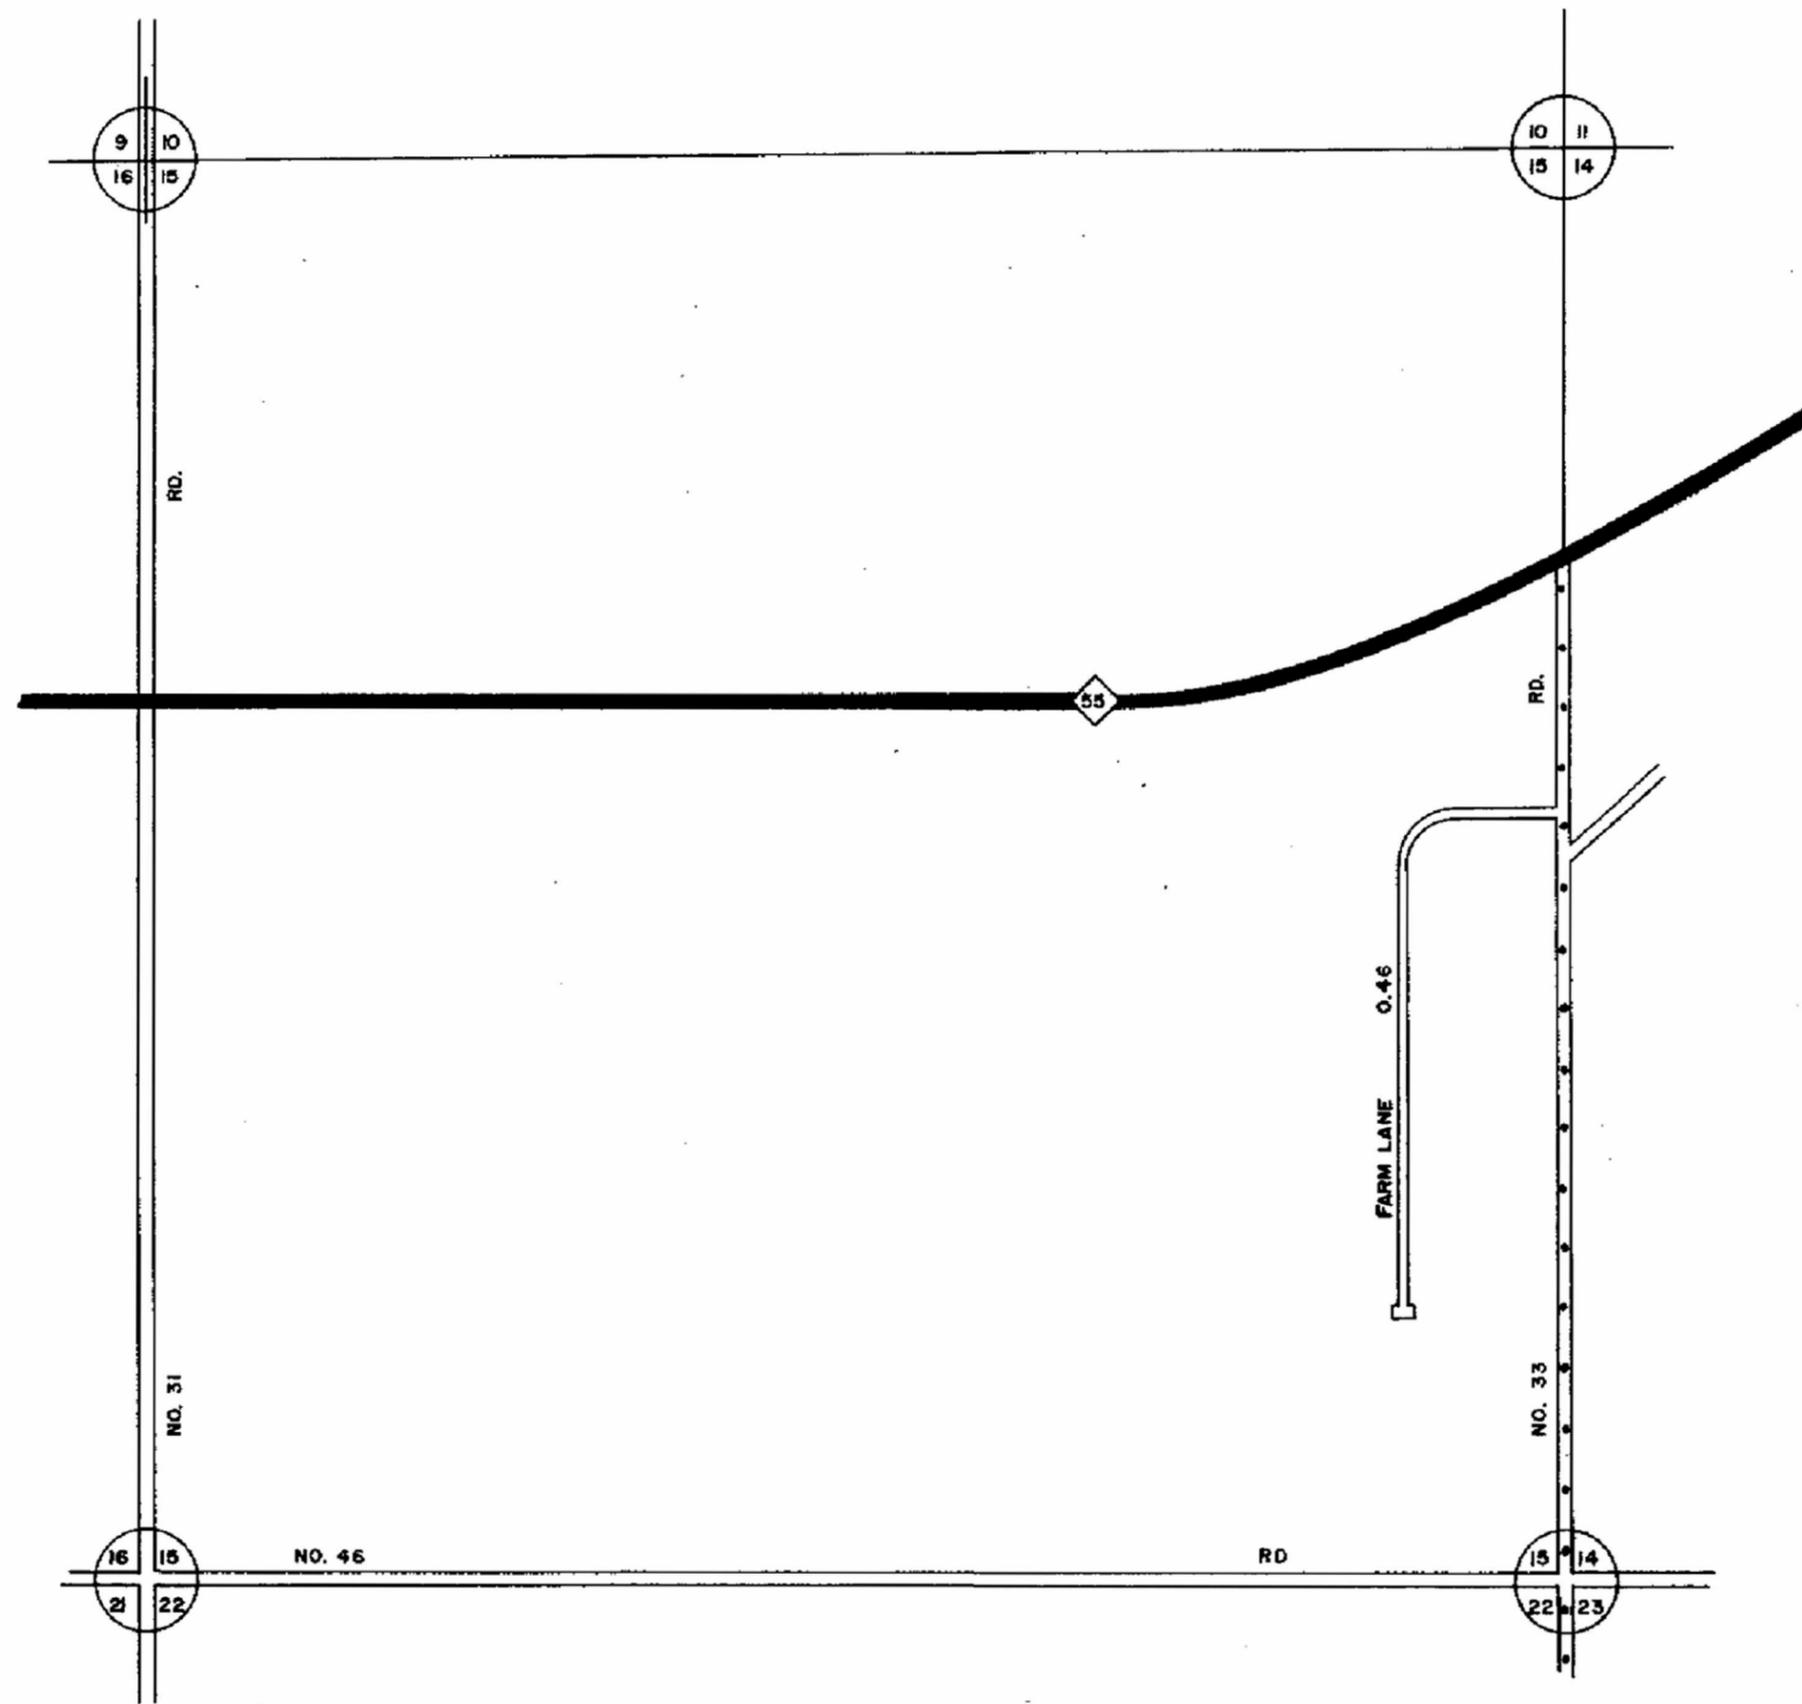

LEGEND

COUNTY LINE	---
CORPORATE LIMITS	----
STATE TRUNKLINE	=====
COUNTY PRIMARY	-----
COUNTY LOCAL	=====
ADJACENT COUNTY	
CITY OR VILLAGE	-----
STREET	-----

LOCAL ROAD SYSTEM
 TOTAL FEET 2498 EQUALS 0.46 MILES
 MILEAGES SHALL BE TO THE NEAREST ONE HUNDREDTH OF A MILE.



CHAIRMAN _____ DATE 1998

NEW 5.1994


REVISED BY _____

DATE _____

TOWNSHIP CHERRY GROVE

SECTION 15 T. 21N. R. 10W

COUNTY WEXFORD

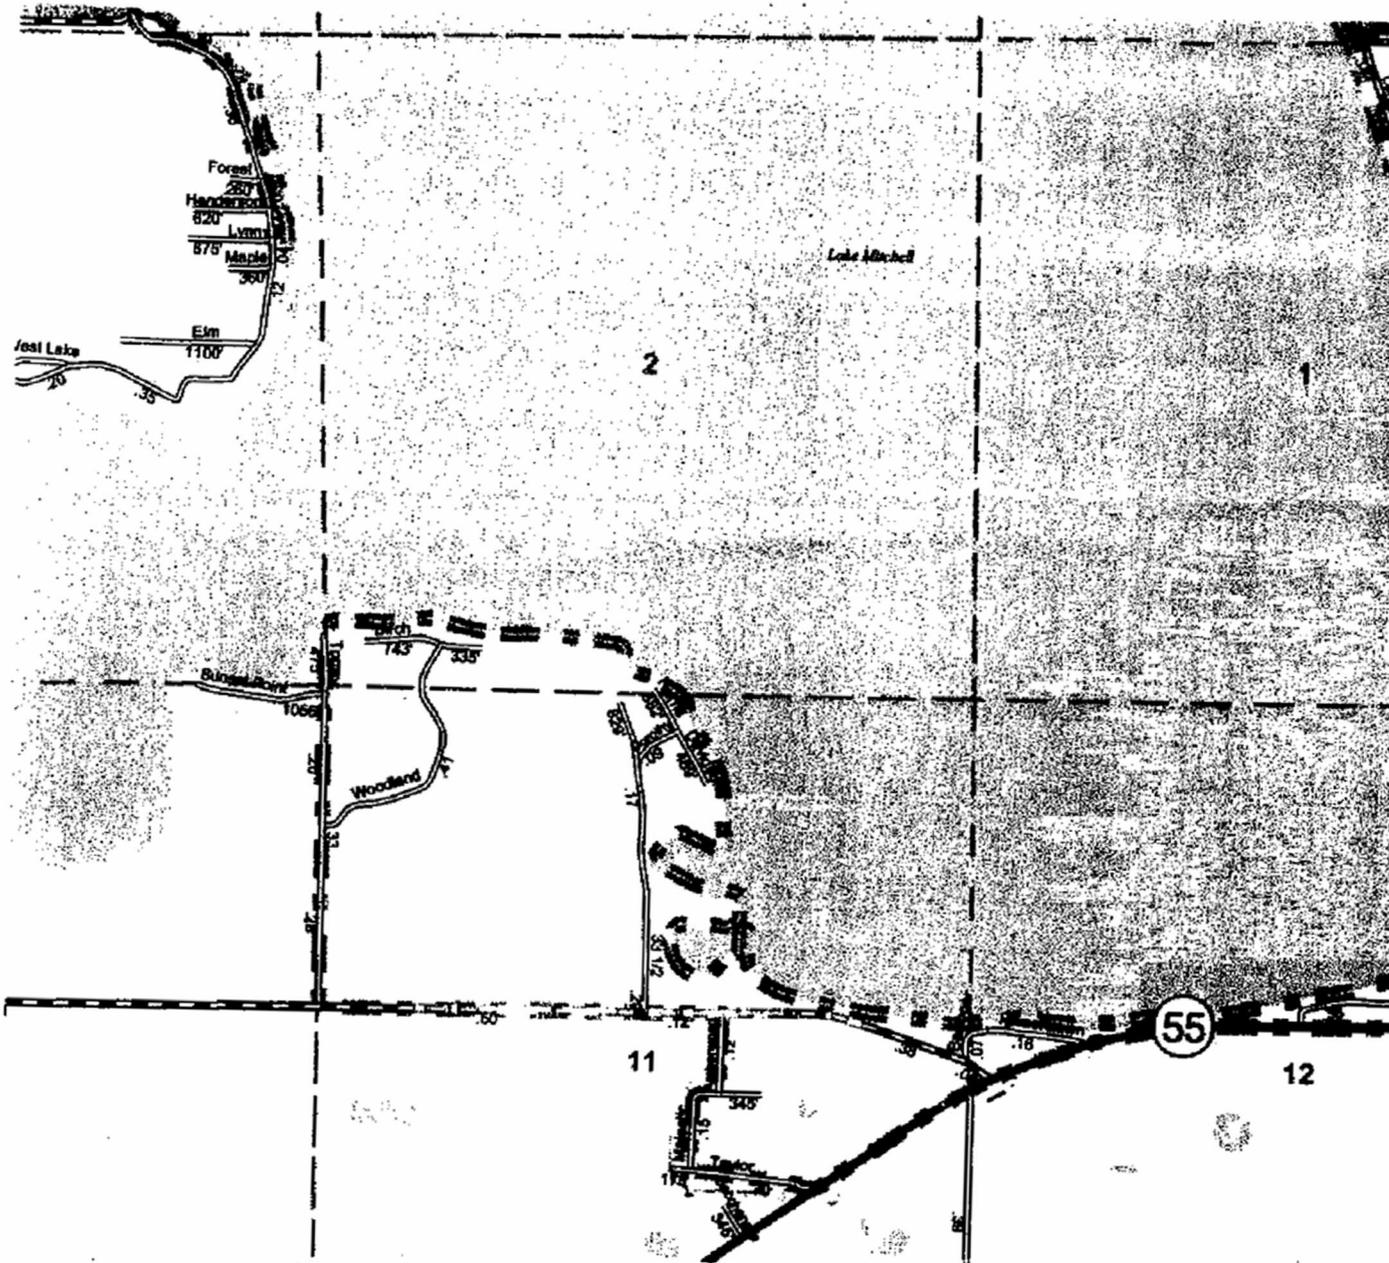

URBAN AREA CERTIFICATION

LEGEND

COUNTY LINE	_____
CORPORATE LIMITS	_____
STATE TRUNKLINE	_____
COUNTY PRIMARY	_____
COUNTY LOCAL	_____
ADJACENT COUNTY	#####
CITY OR VILLAGE STREET	_____
URBAN BOUNDARY	=====

PRIMARY ROAD SYSTEM IS 3.96 MILES


LOCAL ROAD SYSTEM IS 2.47 MILES

I HEREBY CERTIFY THAT THE ROADS SHOWN HEREON BY SYMBOL OR IN RED AS PRIMARY ROADS AND THOSE SHOWN HEREON BY SYMBOL OR IN GREEN AS LOCAL ROADS ARE IN USE AND ARE UNDER THE JURISDICTION OF THE COUNTY ROAD COMMISSION.

CHAIRMAN

REVISED 3-10-04

SCALE: 1 INCH = 1,200 FEET

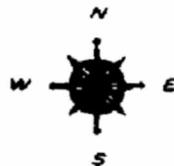

CHERRY GROVE TOWNSHIP, T21N-R10W

SHEET NUMBER 33

